

Work Order ID 56298

February 17, 2010 2:27:28 PM



Page 1

Item ID: D3443-9

Accept



Setup Start



Revision ID:

Stop



Item Name: Pin

Start Date: 2/17/10 Start Qty: 12.00



Cust Item ID:

Required Date: 2/24/10 Req'd Qty: 12.00

Customer:

Reference:

Approvals:

Process Plan:

Date: 10-2-17

Tooling:

Date:

Run Start



QC:

Date:

SPC (Y/N):

Date:

Stop



Sequence ID/
Work Center ID

Operation
Description

Set Up/
Run Hours

Draw
Number

Draw
Rev.

Plan
Code

Accept
Qty

Reject
Qty

Reject
Number

Insp.
Stamp

Draw Nbr

Revision Nbr

D3443

Rev C

100

0.00



Hardinge CNC LATHE SMALL

Hardinge

Memo

0.00

Hardinge CNC Lathe Small

1-TURN AS PER FOLIO FA698 & DWG D3443, 1-FOLIO
REV: C DWG REV: C 12-DEBURR AS REQUIRED

SA 10/02/18

12 ~~0~~

110

QC2- Inspect parts off machine FAI/FAIB

0.00



QC

Memo

0.00

Quality Control

SA 10/02/18

12 ~~0~~

120

QC8- Inspect parts - second check

0.00



QC

Memo

0.00

Quality Control

SA 10/02/18

12 ~~0~~

W/O:		WORK ORDER CHANGES					
DATE	STEP	PROCEDURE CHANGE	By	Date	Qty	Approval Chief Eng / Prod Mgr	Approval QC Inspector

Part No: _____ PAR #: _____ Fault Category: _____ NCR: Yes No DQA: _____ Date: _____

Resolution: _____ Disposition: _____ QA: N/C Closed: _____ Date: _____

NCR:		WORK ORDER NON-CONFORMANCE (NCR)						
DATE	STEP	Description of NC Section A	Corrective Action Section B			Verification Section C	Approval Chief Eng	Approval QC Inspector
			Initial Chief Eng	Action Description Chief Eng	Sign & Date			

NOTE: Date & initial all entries

Work Order ID 56298

February 17, 2010 2:27:28 PM



Page 2

Item ID: D3443-9

Accept



Setup Start



Revision ID:

Stop



Item Name: Pin

Start Date: 2/17/10 Start Qty: 12.00



Cust Item ID:

Required Date: 2/24/10 Req'd Qty: 12.00



Customer:

Reference:

Run Start



Approvals: Process Plan: _____ Date: _____ Tooling: _____ Date: _____

Stop



QC: _____ Date: _____ SPC (Y/N): _____ Date: _____

Sequence ID/ Work Center ID	Operation Description	Set Up/ Run Hours	Draw Number	Draw Rev.	Plan Code	Accept Qty	Reject Qty	Reject Number	Insp. Stamp
--------------------------------	--------------------------	----------------------	----------------	--------------	--------------	---------------	---------------	------------------	----------------

130



Packaging

Packaging

Identify as per dwg & Stock Location: _____

0.00

Memo

0.00

140



QC

Quality Control

QC21- Final Inspection - Work Order Release

0.00

Memo

0.00

9510/02/19 (12)

10/02/23
MF
10-2-19

W/O:		WORK ORDER CHANGES					
DATE	STEP	PROCEDURE CHANGE	By	Date	Qty	Approval Chief Eng / Prod Mgr	Approval QC Inspector

Part No: _____ PAR #: _____ Fault Category: _____ NCR: Yes No DQA: _____ Date: _____

Resolution: _____ Disposition: _____ QA: N/C Closed: _____ Date: _____

NCR:		WORK ORDER NON-CONFORMANCE (NCR)						
DATE	STEP	Description of NC Section A	Corrective Action Section B			Verification Section C	Approval Chief Eng	Approval QC Inspector
			Initial Chief Eng	Action Description Chief Eng	Sign & Date			

NOTE: Date & initial all entries

Picklist Print

February 17, 2010 2:27:32 PM

Page 1

Work Order ID: 56298



Parent Item: D3443-9



Parent Item Name: Pin

Start Date: 2/17/10

Required Date: 2/24/10

Comments: IPP rev A 05.12.19 new issue ec

Start Qty: 12.00

Required Qty: 12.00

Component Item ID/ Item Name	Replacement Item ID	Mfg/ Purch	Bin Item	Primary Location	Last Location	Route Seq ID	Unit of Measure	Qty on Hand	Remaining Qty To Pick	Qty Issued	Date Issued	Status
MDELNR0.500		Purchased	No			110	f	120.6250	1.1053			



Delrin Round Bar .50"



<u>Warehouse</u>	<u>Loc Qty</u>	<u>Loc Code</u>
<u>Location</u>		
Main Warehouse		
MAT	120.625	
102828	4.91	
105353	5.19	
109571	42.825	
18355	64	
3723	3.7	

1.2 ft 2 1/2 10/02/18

W/O:		WORK ORDER CHANGES					
DATE	STEP	PROCEDURE CHANGE	By	Date	Qty	Approval Chief Eng / Prod Mgr	Approval QC Inspector




Part No: _____ PAR #: _____ Fault Category: _____ NCR: Yes No DQA: _____ Date: _____

Resolution: _____ Disposition: _____ QA: N/C Closed: _____ Date: _____

NCR:		WORK ORDER NON-CONFORMANCE (NCR)						
DATE	STEP	Description of NC Section A	Corrective Action Section B			Verification Section C	Approval Chief Eng	Approval QC Inspector
			Initial Chief Eng	Action Description Chief Eng	Sign & Date			

NOTE: Date & initial all entries

8 7 6 5 4 3 2 1

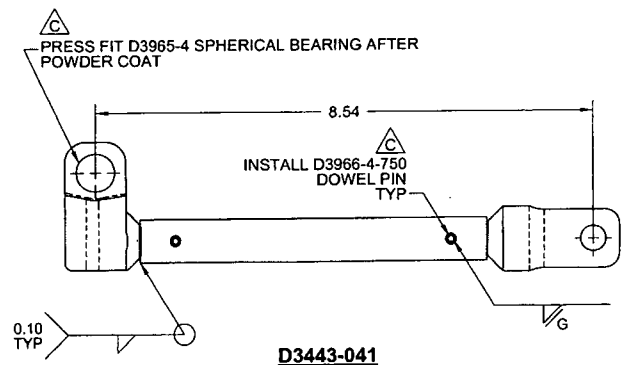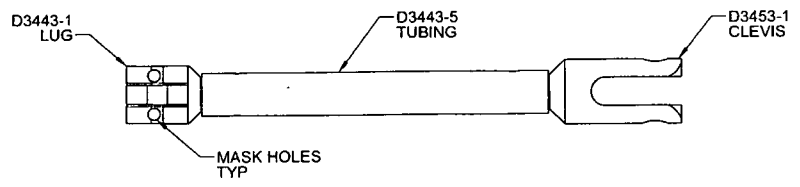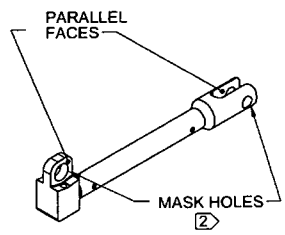





D3443-041

- NOTES:
- 1) MATERIAL: N/A
 - 2) FINISH: POWDER COAT WHITE (4.3.5.2) PER DART QSI 005 4.3
NO POWDER COAT IN HOLES
 - 3) TOLERANCES: PER DART QSI 018 UNLESS OTHERWISE NOTED
 - 4) UNITS: INCHES UNLESS OTHERWISE NOTED
 - 5) BREAK SHARP EDGES: 0.005 TO 0.010 MAX
 - 6) IDENTIFICATION: IDENTIFY WITH DART P/N USING FINE POINT PERMANENT INK MARKER
 - 7) WEIGHT: 1.33 lbs
 - 8) WELD PER DART QSI 004




ITEM	QTY -041	P/N	DESCRIPTION
1	X	D3443-041	STRUT WELDMENT ASSEMBLY
2	1	D3443-1	LUG
3	1	D3443-5	TUBING
4	1	D3453-1	CLEVIS
5	1	D3965-4	BEARING, SPHERICAL
6	2	D3966-4-750	PIN, DOWEL

SHOP COPY
RETURN TO
ENGINEERING
UNCONTROLLED COPY
SUBJECT TO AMENDMENT
WITHOUT NOTICE
WORK ORDER
NO. *50295*
3810-2-17

 RELEASED
9/18/25

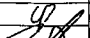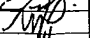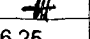C	DRAWING UPDATED TO CURRENT STANDARDS. REVISED NOTE #2 (ZN A8-1, A8-2); 0.820 WAS 0.720 & 1.43 WAS 1.53 (ZN C2-3); 0.551 WAS 0.451 (ZN C1-3); R0.219 WAS R0.050 (ZN C4-3); D3985-4 WAS SPAENAU P/N (ZN C6-1, B5-2); D3986-4-750 WAS McMASTER-CARR P/N (ZN B5-1); REF PAR 09-018		RF	09.06.25
B	ADDED -9 PIN; REMOVED BALL PLUNGER; REVISE TOLERANCE; & Ø.125 WAS #30		RF	05.12.05
A	NEW ISSUE		RF	05.09.02
REV.	DESCRIPTION		BY	DATE
DESIGN	RF	DART AEROSPACE LTD		
DRAWN	RF	HAWKESBURY, ONTARIO, CANADA		
CHECKED		DRAWING NO.	REV. C	
MFG. APPR.		D3443	SHEET 1 OF 4	
APPROVED		TITLE	SCALE	
DE APPR.		STRUT WELDMENT ASSEMBLY NTS		
DATE	09.06.25	COPYRIGHT © 2005 BY DART AEROSPACE LTD THIS DOCUMENT IS PRIVATE AND CONFIDENTIAL AND IS SUPPLIED ON THE EXPRESS CONDITION THAT IT IS NOT TO BE USED FOR ANY PURPOSE OR COPIED OR COMMUNICATED TO ANY OTHER PERSON WITHOUT WRITTEN PERMISSION FROM DART AEROSPACE LTD.		

ITEM	QTY -043	P/N	DESCRIPTION
1	X	D3443-043	STRUT WELDMENT ASSEMBLY
2	1	D3443-3	CLEVIS
3	1	D3443-7	TUBING
4	1	D3966-4-750	PIN

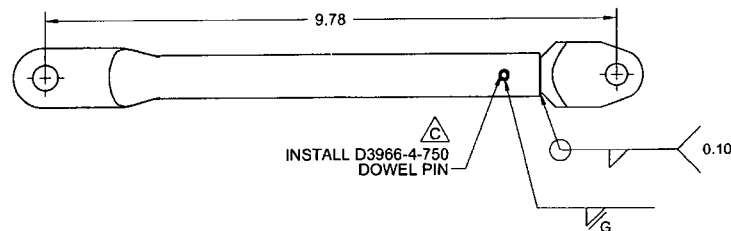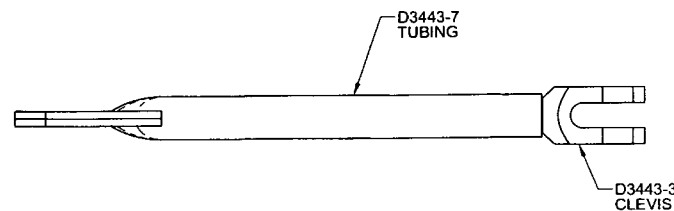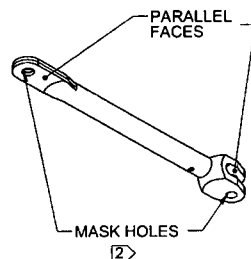



D3443-043

W/0 56298





RELEASED
09/08/25/14

NOTES:

 
- 1) MATERIAL: N/A
- 2) FINISH: POWDER COAT WHITE (4.3.5.2) PER DART QSI 005 4.3
NO POWDER COAT IN HOLES
- 3) TOLERANCES: PER DART QSI 018 UNLESS OTHERWISE NOTED
- 4) UNITS: INCHES UNLESS OTHERWISE NOTED
- 5) BREAK SHARP EDGES: 0.005 TO 0.010 MAX
- 6) IDENTIFICATION: IDENTIFY WITH DART P/N USING FINE POINT PERMANENT INK MARKER
- 7) WEIGHT: 0.97 lbs
- 8) WELD PER DART QSI 004

DESIGN	RF	DART AEROSPACE LTD	
DRAWN	RF	HAWKESBURY, ONTARIO, CANADA	
CHECKED	UP	DRAWING NO.	REV. C
MFG. APPR.		D3443	SHEET 2 OF 4
APPROVED		TITLE	SCALE
DE APPR.		STRUT WELDMENT ASSEMBLY	
DATE	09.06.25	COPYRIGHT © 2005 BY DART AEROSPACE LTD	
THIS DOCUMENT IS PRELIMINARY AND COMPLETION OF THE DESIGN IS SUBJECT TO THE EXISTING CONDITION THAT IT IS NOT TO BE USED FOR ANY PURPOSE OR COPIED OR REPRODUCED IN ANY FORM OR BY ANY MEANS WITHOUT WRITTEN PERMISSION FROM DART AEROSPACE LTD.			



8 7 6 5 4 3 2 1

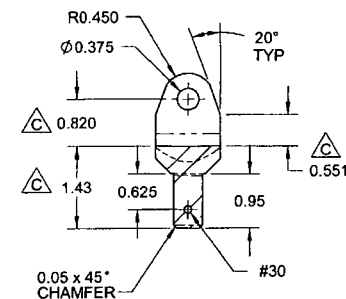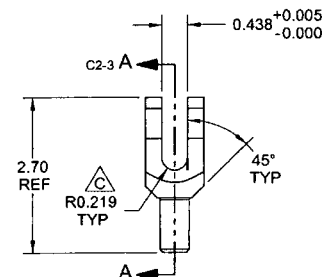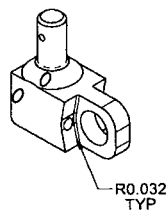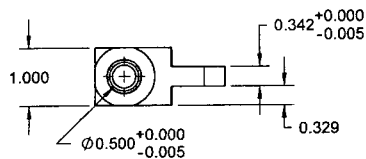

SECTION A-A C4-3

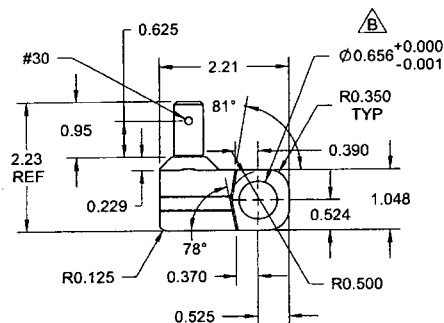

D3443-1 LUG

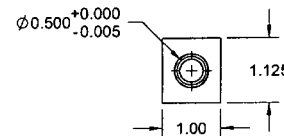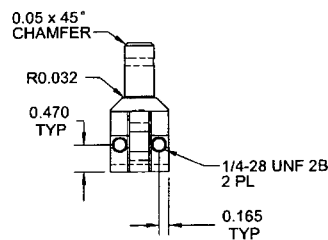

D3443-3 CLEVIS


w/056295

RELEASED
09/08/25/16P




NOTES:

- 1) MATERIAL: D3443-1 = 17-4 SS PER AMS 5604/5643 (REF DART SPEC M17-4B)
D3443-3 = AISI 304 SS ROUND BAR (REF. DART SPEC M304R)
- 2) FINISH: NONE
- 3) TOLERANCES: PER DART QSI 018 UNLESS OTHERWISE NOTED
- 4) UNITS: INCHES UNLESS OTHERWISE NOTED
- 5) BREAK SHARP EDGES: 0.005 TO 0.010 MAX
- 6) IDENTIFICATION: NONE
- 7) WEIGHT: D3443-1 = 0.50 lbs
D3443-3 = 0.35 lbs

DESIGN	RF	DART AEROSPACE LTD	
DRAWN	RF	HAWKESBURY, ONTARIO, CANADA	
CHECKED	RF	DRAWING NO.	REV. C
MFG. APPR.		D3443	SHEET 3 OF 4
APPROVED		TITLE	SCALE
DE APPR.		STRUT WELDMENT ASSEMBLY NTS	
DATE	09.06.25	COPYRIGHT © 2005 BY DART AEROSPACE LTD	
THIS DOCUMENT IS PRIVATE AND CONFIDENTIAL AND IS SUPPLIED ON THE EXPRESS CONDITION THAT IT IS NOT TO BE USED FOR ANY PURPOSE OR COPIED OR COMMUNICATED TO ANY OTHER PERSON WITHOUT WRITTEN PERMISSION FROM DART AEROSPACE LTD.			

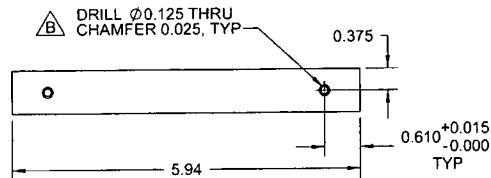



D3443-5 TUBING

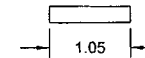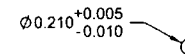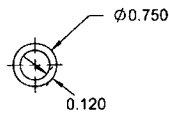

D3443-9 PIN

D3443-9 NOTES:

- 1) MATERIAL: DELRIN II 150R OR ACETRON GP ACETAL (REF. DART SPEC M-DELRIN-R)
- 2) FINISH: NONE
- 3) TOLERANCES: PER DART QSI 018 UNLESS OTHERWISE NOTED
- 4) UNITS: INCHES UNLESS OTHERWISE NOTED
- 5) BREAK SHARP EDGES: 0.005 TO 0.010 MAX
- 6) IDENTIFICATION: NONE
- 7) WEIGHT: N/A

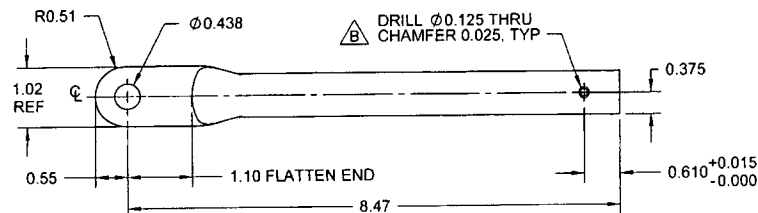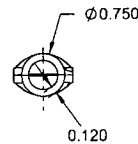

D3443-7 TUBING

D3443-5/-7 NOTES:

- 1) MATERIAL: AISI 316/304 SS SEAMLESS TUBING (REF. DART SPEC M304TR0.750W.120)
- 2) FINISH: NONE
- 3) TOLERANCES: PER DART QSI 018 UNLESS OTHERWISE NOTED
- 4) UNITS: INCHES UNLESS OTHERWISE NOTED
- 5) BREAK SHARP EDGES: 0.005 TO 0.025 MAX
- 6) IDENTIFICATION: NONE
- 7) WEIGHT: D3443-5 = 0.41 lbs
D3443-7 = 0.62 lbs

w/056296

RELEASED
09/06/25 M

DESIGN	RF	DART AEROSPACE LTD	
DRAWN	RF	HAWKESBURY, ONTARIO, CANADA	
CHECKED	<i>[Signature]</i>	DRAWING NO.	REV. C
MFG. APPR.	<i>[Signature]</i>	D3443	SHEET 4 OF 4
APPROVED	<i>[Signature]</i>	TITLE	SCALE
DE APPR.	<i>[Signature]</i>	STRUT WELDMENT ASSEMBLY NTS	
DATE	09.06.25	COPYRIGHT © 2005 BY DART AEROSPACE LTD THIS DOCUMENT IS PRIVATE AND CONFIDENTIAL AND IS SUPPLIED ON THE EXPRESS CONDITION THAT IT IS NOT TO BE USED FOR ANY PURPOSE OR COPIED OR REPRODUCED IN ANY MANNER WITHOUT WRITTEN PERMISSION FROM DART AEROSPACE LTD.	